Declassified and Approved For Release 2012/08/31 : CIA-RDP08C01297R000500100002-6

BAHRAIN - SAUDI ARABIA

Declassified and Approved For Release 2012/08/31 : CIA-RDP08C01297R000500100002-6

Declassified and Approved For Release 2012/08/31 : CIA-RDP08C01297R000500100002-6

Consult Notams, Radio Facility Charts and AOIC Bulletins for the latest information affecting this chart.

USAF AERONAUTICAL APPROACH CHART

Lambert Conformal Conic Projection
Standard Parallels 24°40' and 27°20' Scale 1:250,000

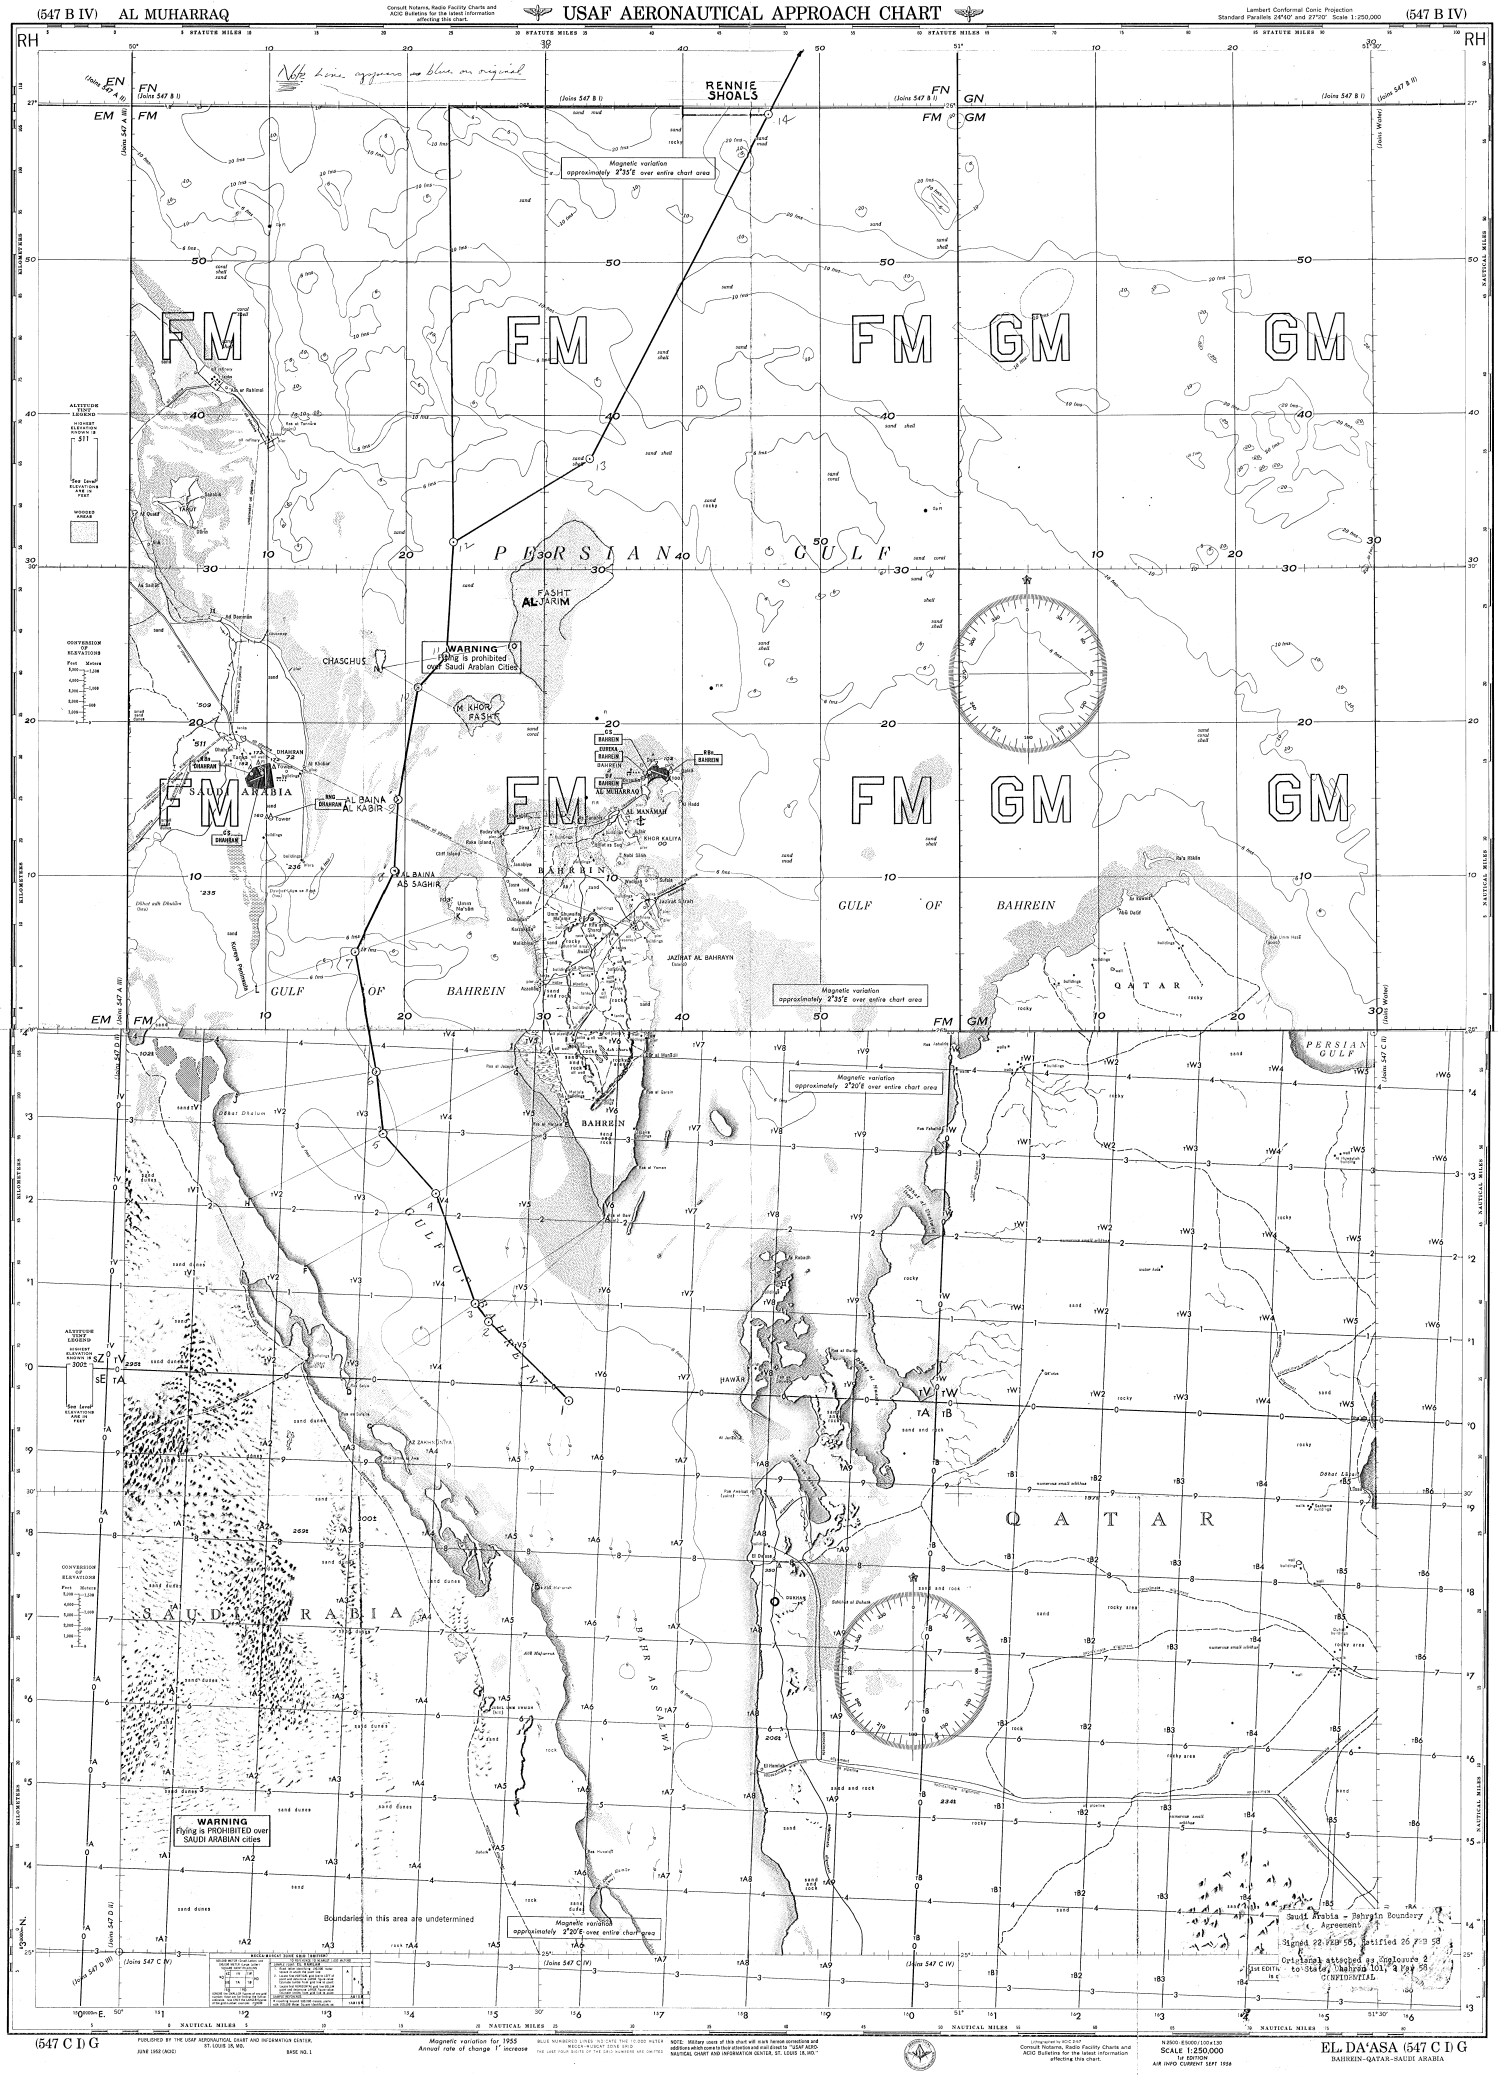

PUBLISHED BY THE USAF AERONAUTICAL CHART AND INFORMATION CENTER, ST. LOUIS 18, MO.
JUNE 1952 (AOC) BASE NO. 1

Magnetic variation for 1955
Annual rate of change 1' increase

BLUE NUMBERED LINES INDICATE THE 1:2,000 METER WECK NUMBER GRID
THE LAST FOUR DIGITS OF THE GRID NUMBERS ARE OMITTED

NOTE: Military users of this chart will mark hence corrections and additions which come to their attention and mail direct to "USAF AERO NAUTICAL CHART AND INFORMATION CENTER, ST. LOUIS 18, MO."

Compiled by AOC ENG
Consult Notams, Radio Facility Charts and AOIC Bulletins for the latest information affecting this chart.

N.B.N.O.-E.N.O.O./100x130
SCALE 1:250,000
1st EDITION
AIR INFO CURRENT SEPT 1956

EL DA'ASA (547 C D G)
BAHREIN-QATAR-SAUDI ARABIA

Declassified and Approved For Release 2012/08/31 : CIA-RDP08C01297R000500100002-6